
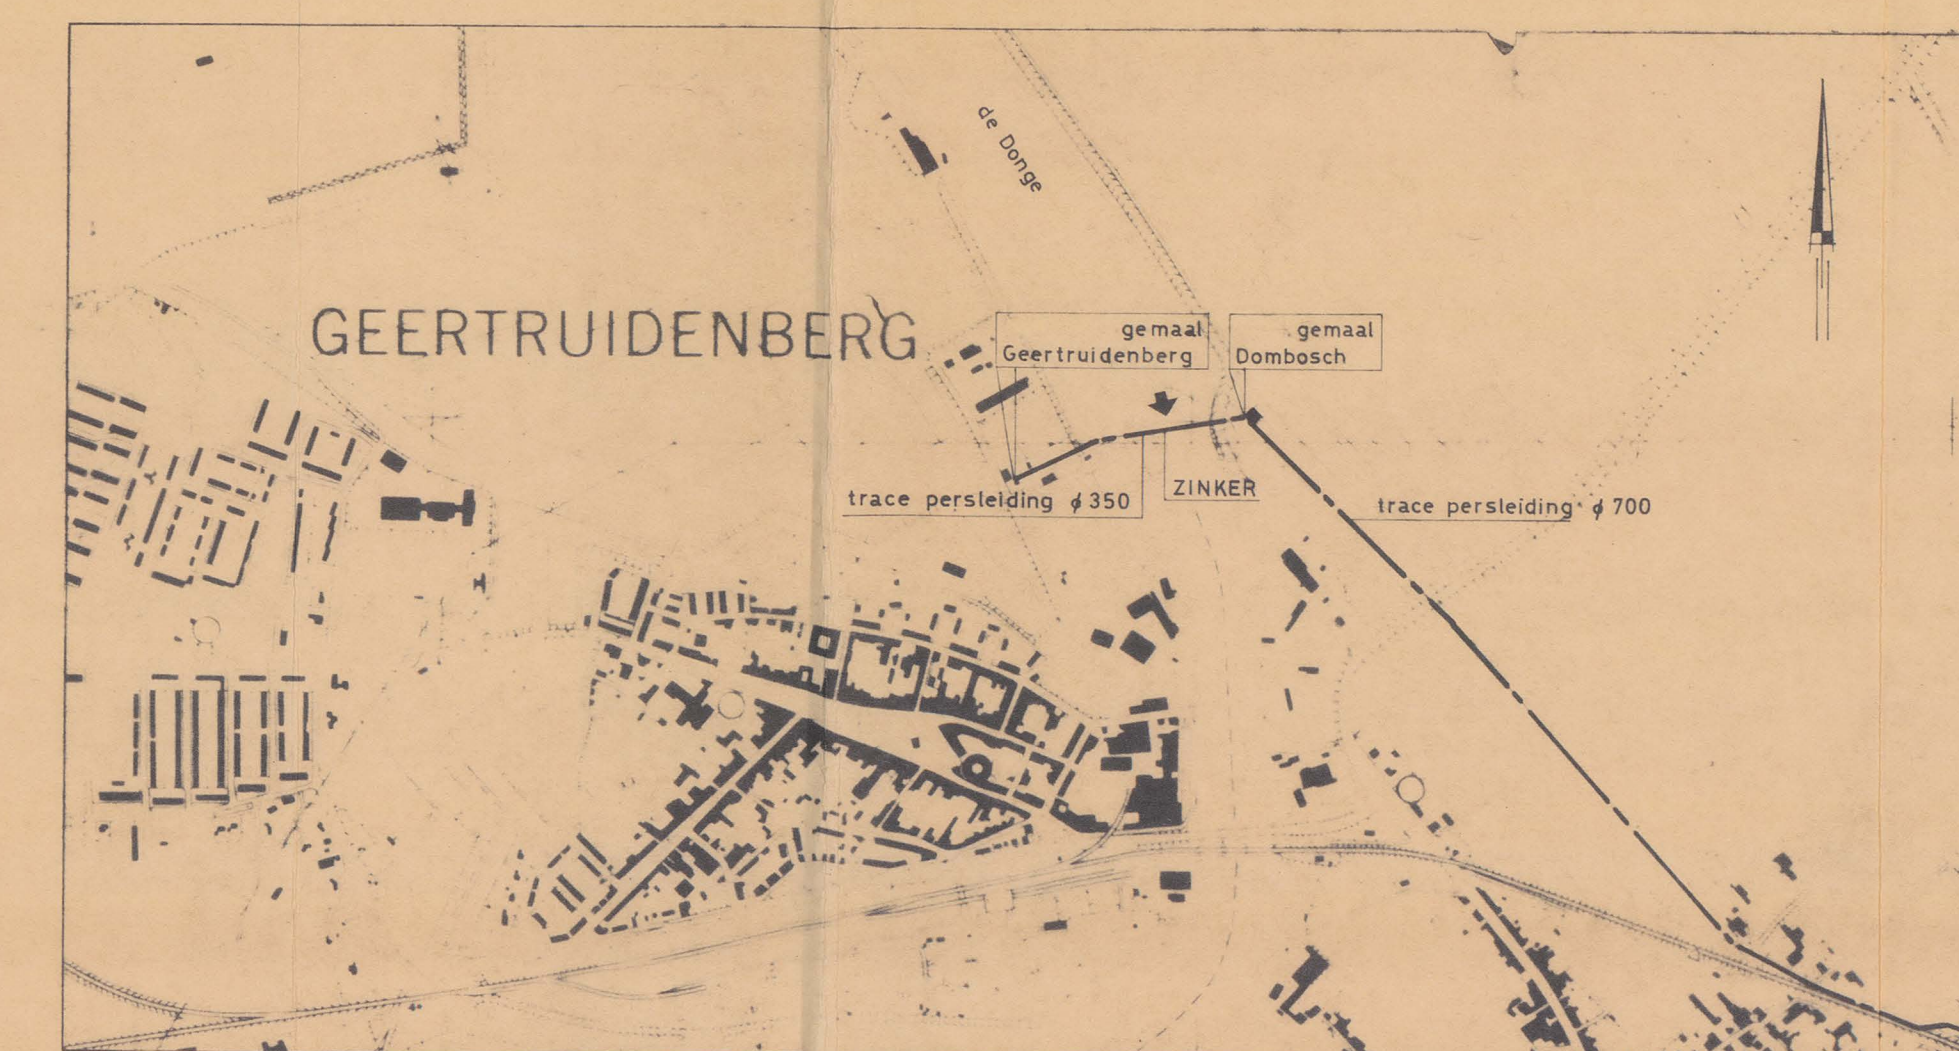


SCHAAL 1 : 20

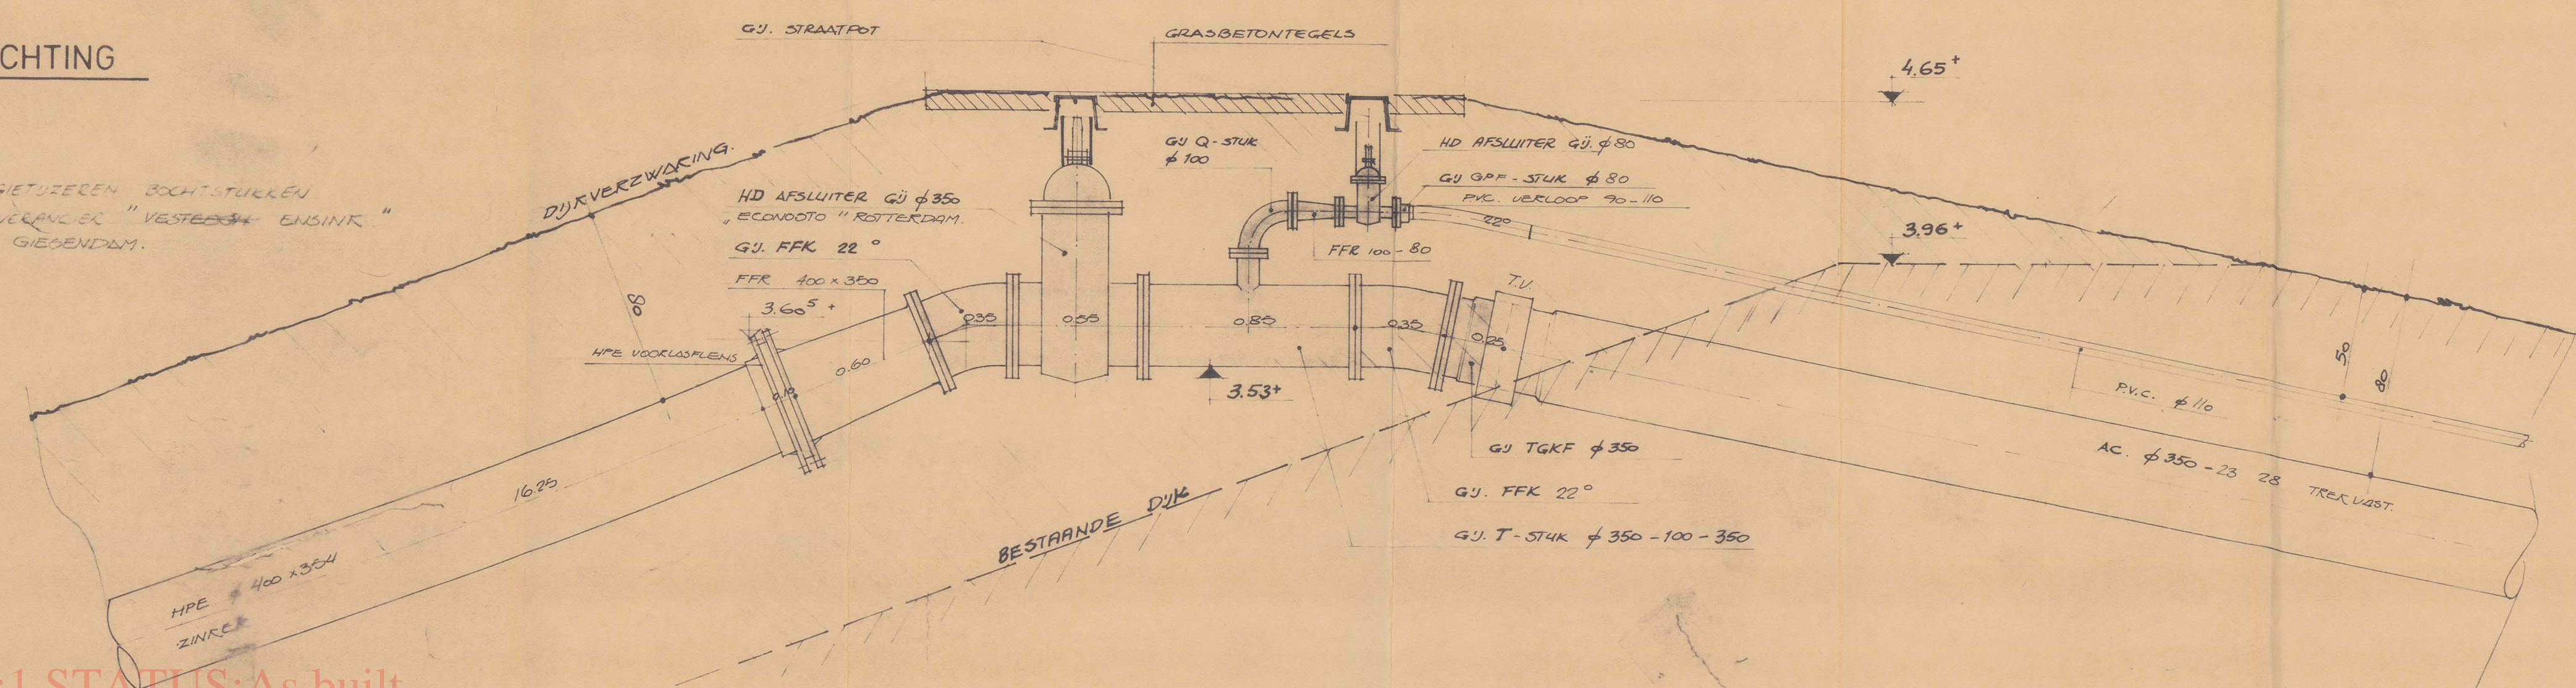

OVERZICHT    SCHAAL 1:10000

TGRV 1-3 C

[illegible]

0652669522-B

ZTP00024-15-002 REV:1 STATUS:As built